


# ATTALIA

## W 1/2 OF NE 1/4 OF SEC. 10-7-31 51

~~BOOK 15 PAGE 30~~

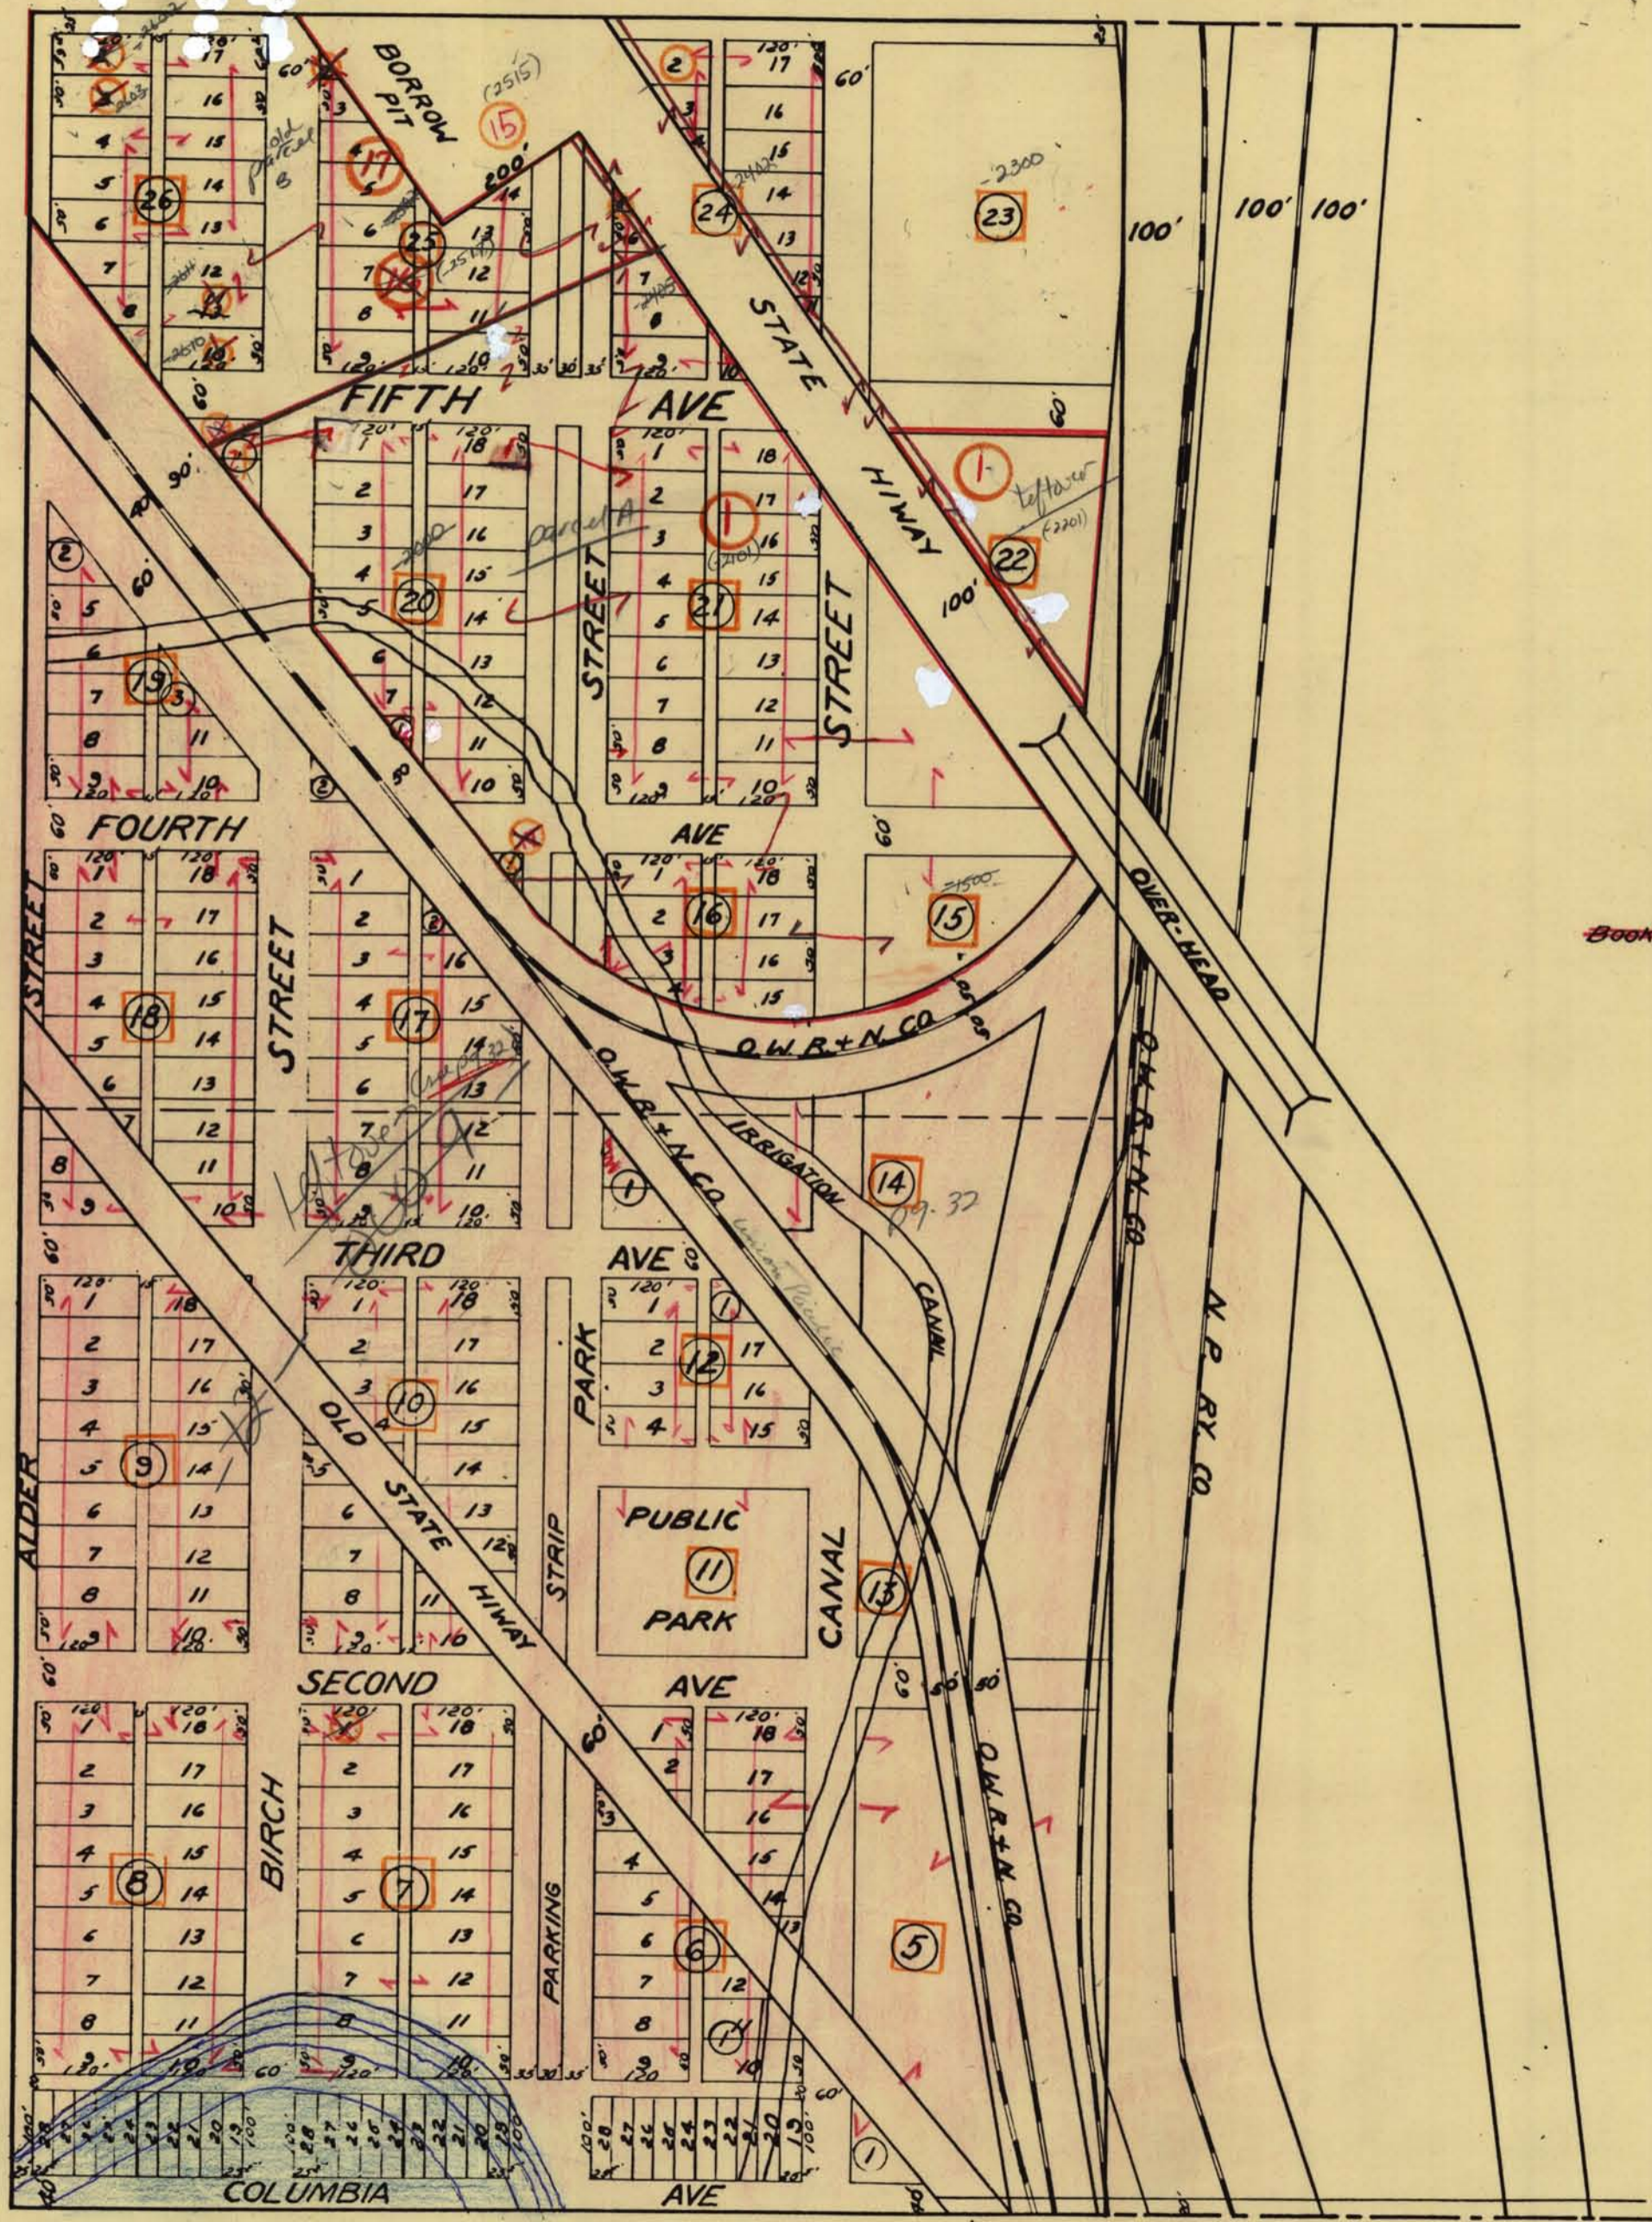

~~Page 53~~  
~~Page 54~~

page 37  
~~BOOK 15 PAGE 34~~

~~PAGE 6~~  
page 40

Scale 1" = 200'